


Section 35 T09N-R01W Bloomington	Section 36 T09N-R01W Bloomington
Section 02 T08N-R01W Perry	Section 01 T08N-R01W Perry

Per_U01 (#10171)
SECTION CORNER
01 & 02-T08N-R01W
ROAD NAIL
FOUND FLUSH

Blm_U25 (#10173)
SECTION CORNER
35 & 36-T09N-R01W
MAG NAIL
FOUND FLUSH

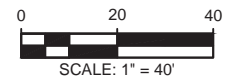


WITNESS MONUMENT TIES			
ID	BEARING	DISTANCE	DESCRIPTION
Witness A	S 53d E	72.9'	Cut + in northwest anchor bolt of signal pole
MONUMENT ACCESSORIES			
Other survey grade monuments that were located in the vicinity and their relation to the monument.			
(#10171)	N 89d40'57" E	114.96'	3123580.28, 1426838.18 Road nail found flush at Per_U01, the section corner common to Sections 01 and 02-T08N-R01W, Perry Township
(#10251)	N 37d57'40" E	54.61'	3123498.92, 1426880.60 Cut + in the back of curb at the east end of the sidewalk
(#10253)	N 75d42'21" W	127.73'	3123341.55, 1426869.08 Cut + in the northeast back of curb corner of curb inlet
(#10256)	S 2d8'36" E	53.50'	3123467.33, 1426784.08 Cut + in the east rim of 2.2' diameter sanitary sewer rim on the west side of Smith Road

NOTES:

- Field work was performed on 9/25/2018 and 9/26/2018.
- Monroe County Surveyor's Field Book 52, page 44 and Field Book 52, page 45.
- Project Name: INDOT Network 2018, Field work by: RSO & CAR, Drawn by: RSO, Reviewed by: RSO, TER & SRB.
- The basis of bearings is Grid North NAD83(2011), Indiana West Zone, Epoch 2010.0000, Geoid Model G2012BU7, Datum NAD83_NO_TRANS, US Survey Feet, derived from GPS observations utilizing the Indiana Real-Time Network (INCORS). Distances obtained with GPS have not been adjusted to ground. Coordinate data and witness ties were collected with a Javad Triumph LS Network Rover.
- Vicinity sketch was compiled per 2014 aerial photography.
- This corner was witnessed by the Monroe County Surveyor, Kevin Enright, on April 8, 2008 and accepted by the Surveyor Review Board on June 10, 2008. We collected coordinates on the known monument in preparation for an upcoming INDOT resurfacing project in the area. Historic research has not yet been performed to prove the validity of this monument.

▲ Monument Description: Mag nail found flush

State Plane Grid Coordinates: Point No.: 10173 Northing: 1426837.54', Easting: 3123465.32'

SHEET 1 OF 2	MONUMENT RECORD CORNER ID: Blm_U25	Section Corner Section 35 & 36- T09N-R01W Bloomington Township Monroe County, Indiana	 OFFICE OF THE MONROE COUNTY SURVEYOR Trohn Enright-Randolph <i>Monroe County Surveyor</i> Rachel Savich Oser <i>Professional Surveyor</i> 119 West 7th Street, Bloomington, IN 47404 (812) 349-2570
-----------------------	--	---	--

Photos were taken on 9/25/2018 with an iPhone 6s




Trohn Enright-Randolph
Trohn Enright-Randolph
Monroe County Surveyor




Accepted by the Monroe
County Surveyor Review Board
on 12/06/2018



Rachel Oser
Rachel Savich Oser, State of Indiana
Professional Surveyor No. 21100022

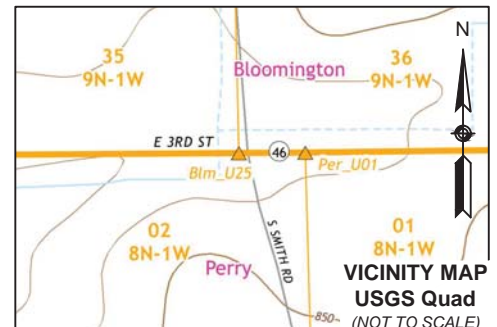

SHEET 2 OF 2	MONUMENT RECORD CORNER ID: Blm_U25	Section Corner Section 35 & 36- T09N-R01W Bloomington Township Monroe County, Indiana	 OFFICE OF THE MONROE COUNTY SURVEYOR Trohn Enright-Randolph Monroe County Surveyor Rachel Savich Oser Professional Surveyor 119 West 7th Street, Bloomington, IN 47404 (812) 349-2570
-----------------------	--	---	--

MONUMENT RECORD

Corner I.D. #

U-25

STATE OF INDIANA - COUNTY OF MONROE

Section Thirty-five, Township 9 North, Range 1 West


Monument Description & Remarks: 3" ROAD NAIL (per D. STANGER 11-4-97)
Brass Disk set in concrete, flush w/black-
top, at SE corner of section. Corner witnessed 11/9/94 by Indiana State
Highway Survey Location Team (Don Stanger).

Recovery Tie Drawing

S.E. CORNER SEC. 35, T. 9N., R. 1W.

BLOOMINGTON TWP. - MONROE CO.

Tie Sheet Change, field inspected.
K.E. 9-20-98

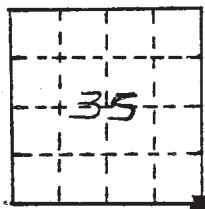

Type Monument 3" ROAD NAIL
BRASS DISK SET IN CONC.
Depth FLUSH w/ BLK TOP.
By D.W. STANGER (PARTY #3)
Date Nov. 9, 1994

State Form 40180

"4" CUT TOP
S.W. BOLT
STOP LIGHT
BASE

"4" CUT TOP
S.E. BOLT STOP
LIGHT BASE

19.294m

21.159m

18.593m

"4" CUT TOP
N.W. BOLT
STOP LIGHT BASE

● At Corner



Not To Scale

State of Indiana
County of Monroe

Space
Reserved For
Recording
Officer

I, Michael W. Friley, County Surveyor, hereby certify
that this document was prepared under my direction in
accordance with the provisions of Section 17-3-64-4
through 17-3-64-8 of the Indiana Code, being Acts of 1965,
Chapter 319; and the above data is given under my hand and
seal this 20th day of September, 1995 A.D.

Indiana Registered Land Surveyor No. _____ or

Indiana State Highway Survey Location Team
United States Government Agency

Title _____

BRASS Disk was
Never set...
per Don STANGER
11/4/97 "Mike
was supposed
to set but,
Never did."

Corner is 3"
ROAD NAIL